RECEIVED

APR 6 2009

BLAINE COUNTY LAND USE & BUILDING

BOND

South Central District Health
Keeping your family & community healthy

Subsurface Sewage Permit Application

SCALED SITE PLANS REQUIRED

OWNER NAME: William E Green	LEGAL DESCRIPTION: Twn 2N, Rng 18E, Sec 19, Q Sec				PERMIT # 704612
MAILING ADDRESS: PO Box 4726					RP1M0000000300A
CITY: Ketchum	ST: Id	ZIP: 83340	SUBJECT PROPERTY STREET/GRID ADDRESS: 121 N Colorado Gulch Rd		
			CITY/ST/ZIP: Blaine County 83333		LOT SIZE
PHONE HOME: 208 720 7360	WORK: 208 309 0142		SUBDIVISION: Commodore Lode #40	LOT	BLOCK
INSTALLER: KD Excavation	PHONE		☑ 232 – NEW SYSTEM ☐ 233 – REPLACEMENT	BDRMS or EST FLOW - GAL/DAY: 250 GPD	
GENERAL CONTRACTOR: Green Const	PHONE: 720-4360		WATER: ☐ PUBLIC/SHARED WELL ☑ PRIVATE WELL		

I understand that the installation must comply with State of Idaho and District Health rules, regulations, and standards; that District Health must be notified two (2) working days prior to completion of installation, and that permits are valid for one (1) year from date of issue. **Permits are non-refundable, non-transferable.**

SIGNATURE: William Green DATE: 7-26-06

FEE: $330.00 RECEIPT #: 2020753 RECEIVED BY: P. Larson DATE: 7-28-06

Site Evaluation and System Specifications Computer #: 00706-12747 Program: 680 06914

TEST HOLES	DEPTH	PROFILE
	6'	CL

TYPE OF SYSTEM: Pressure Distribution

PLANS APPROVED: YES ☑ NO ☐ ORIG. PERMIT #

SEPTIC TANK SIZE: 1,000 PUMP CHAMBER SIZE: 1,000

DRAINFIELD SIZE AND DIMENSIONS: 840 ft

COMMENTS: 6 Trenches 3'x 56' w/ approved product

INSTALL PER DESIGN BY GALENA ENGINEERING

RECEIVED OCT 12 2016 BLAINE COUNTY LAND USE & BUILDING SERVICES

APPROVE FOR PERMIT YES ☑ NO ☐ REHS SIGNATURE: Bob Enich DATE: 8/7/06

On-Site Construction Inspection Date Contacted: Date Inspected:

Tank Size: 1,000	Drainfield Sq. Footage: 1,320	Pump Chamber Size: 1,000 J.P.
Manufacturer: Jor Precast	Material: 66- 5' Hancors	Screen: Filter ☑ Quick Disconnect: ☑
Lid Depth: Grade	Cover Depth: 18-36"	Float/Timer setup: ☑ Riser to Grade: ☑
*Meets Regulations: ☑ Yes ☐ No *Meets all Setbacks: ☑ Yes ☐ No	*Meets Regulations: ☑ Yes ☐ No *Meets all Setbacks: ☑ Yes ☐ No	Alarm Location: House exterior south side.

Comments: Pump & distribution valve working normally 4-1-09
Squirt height ~36"
Distribution valve in heated vault

COMPLETED BY: Bob Enich APPROVED: YES ☑ NO ☐ DATE: 4-1-09

B-1 EXHIBIT

8-12-07 2024816

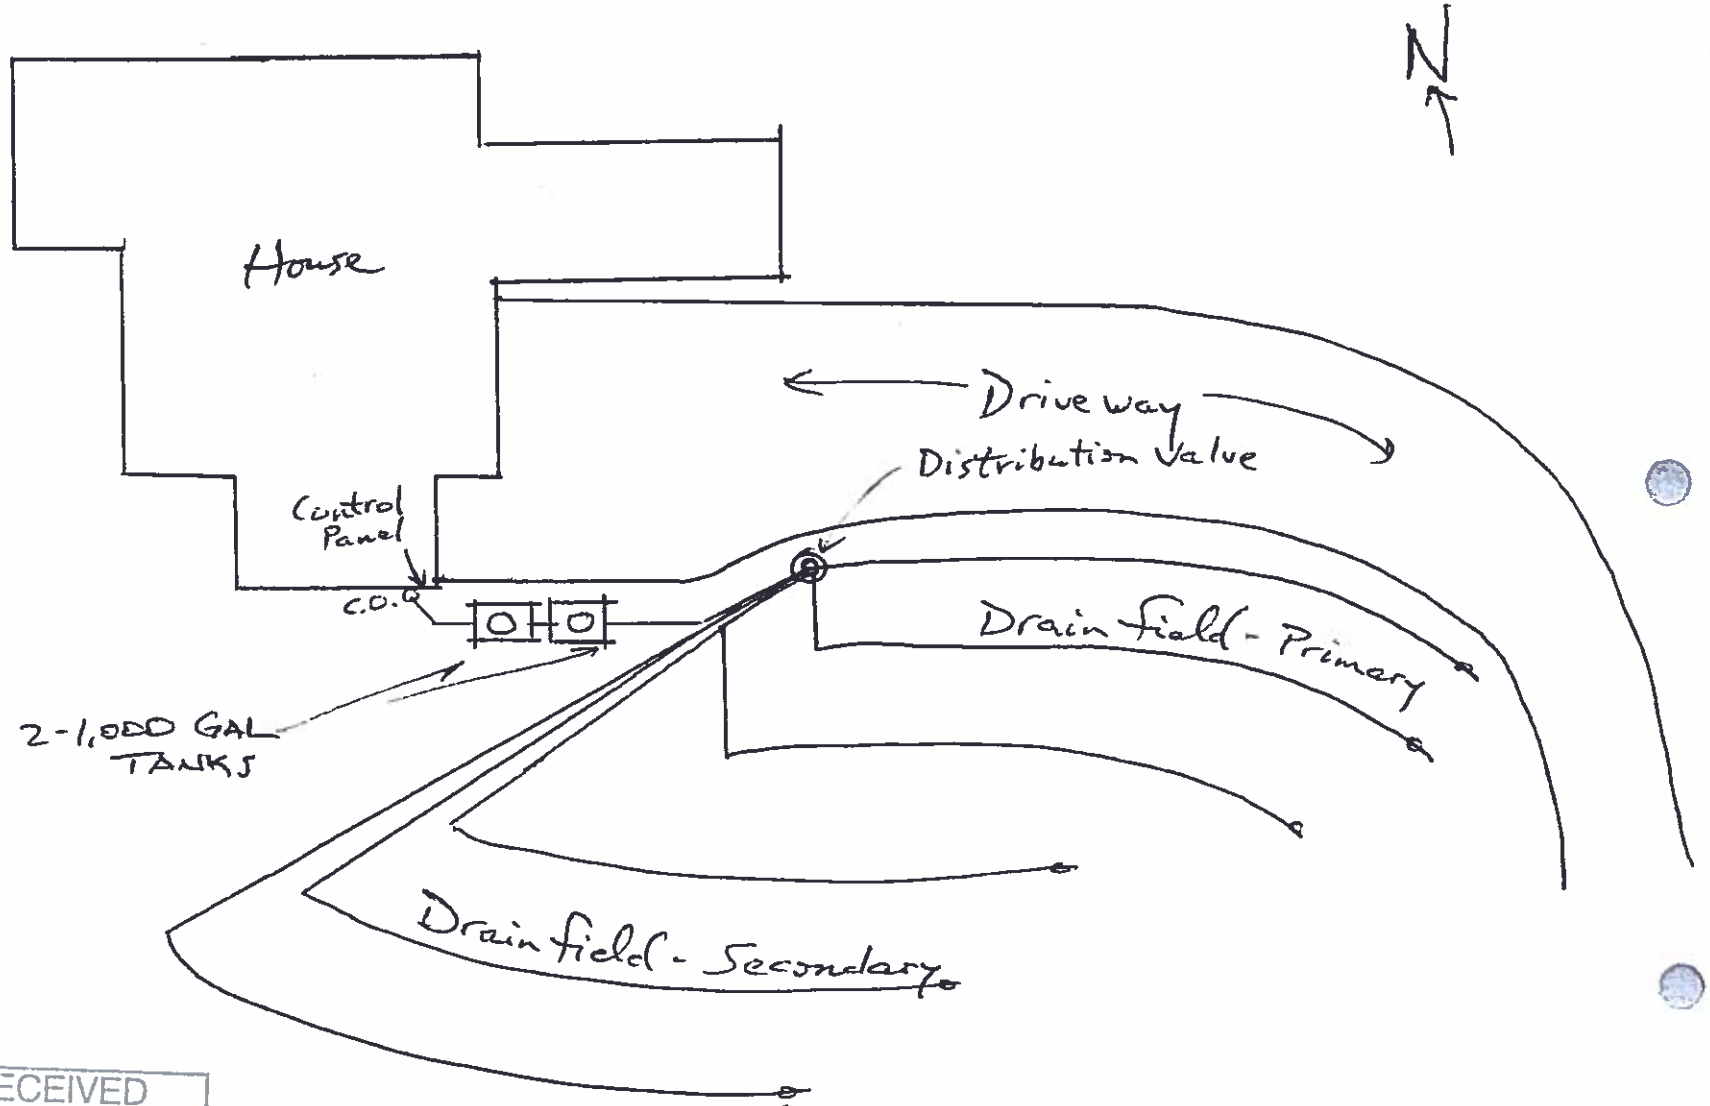

As-Built
9/8/08

RECEIVED
OCT 12 2016
BLAINE COUNTY
LAND USE & BUILDING SERVICES

SCANNED

EXHIBIT B-1